

HAR.
M

MISSISSIPPI BOARD OF WATER COMMISSIONERS

14

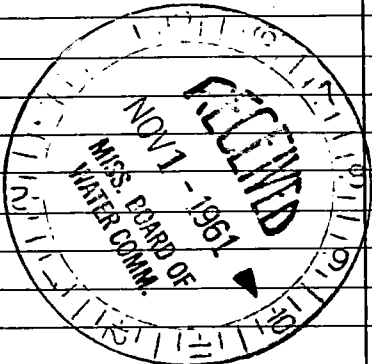
WATER WELL DRILLERS LOG

M-302

10-26-61

Date: 10-26, 1961, Driller: C.T. SWITZER County Harrison

(Name)

| (1) Owner of Land: | Description & Color of Materials Sand, Clay, Red Clay, Shell, etc. | Thick- ness Feet | Depth Feet |
|--|--|--|--|
| (Name) <u>A L Dorsey</u> (Address) <u>RT #2 Biloxi Hwy</u> | <u>clay</u> <u>sand</u> <u>clay</u> <u>sand fine</u> <u>clay</u> <u>sand fine</u> | <u>10</u> <u>20</u> <u>105</u> | <u>10</u> <u>20</u> <u>105</u> |
| (2) Location: <u>1/4</u> , <u>1/4</u> , Sec. <u>T</u> R <u>R</u> <u>_____</u> miles <u>_____</u> of <u>_____</u> (distance) (direction) (Nearest Town) | <u>clay</u> <u>sand</u> <u>clay</u> | <u>0</u> <u>10</u> <u>20</u> | <u>10</u> <u>20</u> <u>105</u> |
| (3) Topography: <u>X</u> (Hilly) (Flat) (Level) | <u>sand fine</u> <u>clay</u> | <u>105</u> <u>120</u> | <u>120</u> <u>160</u> |
| (4) Purpose of Well: <u>Domestic</u> (Domestic Irrigation Municipal, Industrial, Other) | <u>sand fine</u> <u>clay</u> <u>sand fine</u> <u>clay</u> | <u>160</u> <u>210</u> <u>350</u> <u>360</u> | <u>210</u> <u>350</u> <u>360</u> <u>450</u> |
| Information upon completion of well: | | | |
| (1) Diameter <u>2"</u> inches. | <u>sand gravel</u> | <u>450</u> <u>483</u> | <u>483</u> |
| (2) Total Depth <u>483</u> feet. | (6) Were any formations sealed against pollution? <u>X</u> yes, <u>_____</u> no. | If YES depth of formation <u>_____</u> | Why <u>Health Dept Requirement</u> |
| (3) Water Level <u>10'</u> feet below top of ground. | Drillers Remarks: <u>_____</u> | (Use Back Side) | Well No. <u>_____</u> |
| (4) Cased to <u>483</u> , Size <u>2"</u> |  | (Use Back Side) | Well No. <u>_____</u> |
| (5) Screen: Size <u>2"</u> , Length <u>10</u> | Mail this copy to Board of Water Commissioners 429 Miss. St. Jackson, Miss. | (Use Back Side) | Well No. <u>_____</u> |

UNITED STATES DEPARTMENT OF AGRICULTURE

Form No. 109 (Revised 1-15-54)

UNITED STATES DEPARTMENT OF AGRICULTURE
OFFICE OF THE SECRETARY

(1) Name of land

Address

County

(2) Location of land

(3) Description of land

(4) Purpose of land

(5) Information upon completion of sale

(6) Director

(7) Total profit

(8) Water cover

ground

(9) Used for

(10) Former use

(11) Area and number of acres of land

(12) Date of purchase

(13) Date of sale

(14) Other remarks