

HAR.

MISSISSIPPI BOARD OF WATER COMMISSIONERS

M

10-12-61

WATER WELL DRILLERS LOG

M-304

Date: 10/12, 1961, Driller: C. T. SWITZER WELL NO. 60 County Harrison

(Name)

(1) Owner of Land: Walter Wheat  
(Name)

Moran Ave  
(Address)

(2) Location: 1/4, 1/4, Sec. T R,  
\_\_\_\_\_ miles \_\_\_\_\_ of \_\_\_\_\_  
(distance) (direction) (Nearest Town)

(3) Topography: X  
(Hilly) (Flat) (Level)

(4) Purpose of Well: Domestic  
(Domestic Irrigation  
Municipal, Industrial, Other)

Description & Color of Materials Sand, Clay, Red Clay, Shell, etc.	Thick- ness Feet	Depth Feet
clay	0	15
sand good.	15	30
clay	35	50
sand fine	50	60
clay	60	105
sand good.	105	150

Information upon completion of well:

(1) Diameter 2" inches.

(2) Total Depth 150' feet.

(3) Water Level 1' feet below top of ground.

(4) Cased to 150, Size 2"

(5) Screen: Size 2", Length 10


(6) Were any formations sealed against pollution?

X yes, \_\_\_\_\_ no.

If YES depth of formation \_\_\_\_\_

Why Health Dept Requirement

Drillers Remarks: \_\_\_\_\_

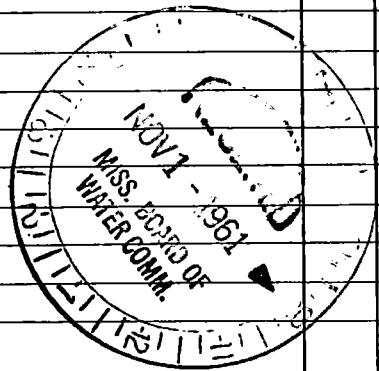

(Use Back Side)

Well No.

