

HAR.

MISSISSIPPI BOARD OF WATER COMMISSIONERS

M
9-13-61

WATER WELL DRILLERS LOG

M-307

Date: Sept 13, 1961, Driller: C. T. SWITZER WELL CO. County: Harrison

(Name)

(1) Owner of Land: Loren E. Barton

(Name)

Pondarosa Sub. Biloxi

(Address)

(2) Location: 1/4, 1/4, Sec. T R R

 miles of
(distance) (direction) (Nearest Town)

(3) Topography: A

(Hilly) (Flat) (Level)

(4) Purpose of Well: Domestic

(Domestic Irrigation
Municipal, Industrial, Other)

Description & Color of Materials Sand, Clay, Red Clay, Shell, etc.	Thick- ness Feet	Depth Feet
clay	0	12
sand	12	20
clay	20	80
sand	60	80
clay	80	169
sand	169	188
clay	0	12
sand	12	20
clay	20	80
sand	60	80
clay	80	169
sand	169	188

Information upon completion of well:

(1) Diameter 2" inches.

(2) Total Depth 188 feet.

(3) Water Level 19 feet below top of ground.

(4) Cased to 324, Size 2"

(5) Screen: Size 2", Length 10'


(6) Were any formations sealed against pollution?

X yes, no.

If YES depth of formation

Why Health Dept Requirement

Drillers Remarks:

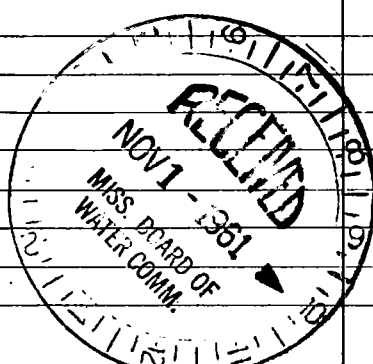

(Use Back Side)

Well No.

Handwritten notes at the top of the page, including the word "Lecture" and other illegible scribbles.

Handwritten notes in the middle section, separated by a horizontal line. Includes the word "Lecture" and other illegible scribbles.

Handwritten notes at the bottom of the page, including the word "Lecture" and other illegible scribbles.