

WATER WELL DRILLERS LOG

M-322

6-13-60

Date June 13, 1960, Driller C.J. Switzer Well Co. County Harrison

(1) Owner of Land: E. U. Shove
 1210 Division Street
 Biloxi, Miss. (Address)
 (Name)

(2) Location: $\frac{1}{4}$, $\frac{1}{4}$, Sec. T R
 in city of
 miles of Biloxi
 (distance) (direction) (Nearest Town)

(3) Topography: (Hilly) (Flat) (Level)

(4) Purpose of Well: domestic
 (Domestic Irrigation
 Municipal, Industrial, Other)

Description & Color of Materials Sand, Clay, Red Clay, Shell, etc.	Thick- ness Feet	Depth Feet
Stratified sand		18
Coarse sand	18	84

Information upon completion of well:

(1) Diameter 4" inches.

(2) Total Depth 84' feet.

(3) Water Level -9' feet below top of ground.

(4) Cased to 84', Size 4"


(5) Screen: Size 10 ga, Length 20'
4" ss.

(6) Were any formations sealed against pollution?
 yes, no.

If YES depth of formation 10 feet

Why Health dept. requirement

Drillers Remarks:

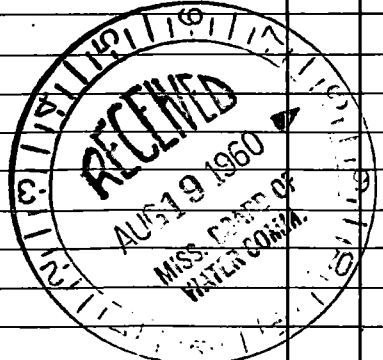

(Use Back Side)

Well No.

