

HAR.

M

3-1-61

WATER WELL DRILLERS LOG

M-328

Date: 3-1-61, 19, Driller: C.T. Smitz Will Co County Harrison

(Name)

(1) Owner of Land: Sydney Ralls (Name) RT 2, Beloxi, Miss. (Address)

(2) Location: 1/4, 1/4, Sec. T R, miles of (distance) (direction) (Nearest Town)

(3) Topography: (Hilly) (Flat) (Level)

(4) Purpose of Well: Domestic (Domestic Irrigation, Municipal, Industrial, Other)


Table with 3 columns: Description & Color of Materials, Thickness Feet, Depth Feet. Rows include clay, sand, good sand, clay & sand streak, fine sand, and sand.

Information upon completion of well:

- (1) Diameter 2 inches.
(2) Total Depth 350 feet.
(3) Water Level 32- feet below top of ground.
(4) Cased to 350', Size 2"
(5) Screen: Size 2", Length 10'
(6) Were any formations sealed against pollution? yes, no.

If YES depth of formation 10 ft
Why Health Dept. Requirement

Drillers Remarks:

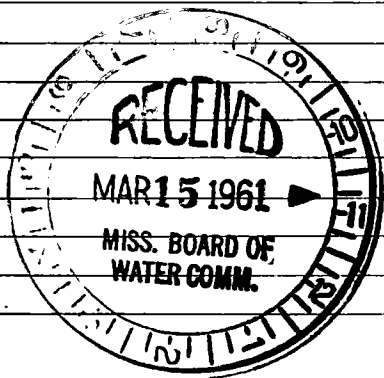

(Use Back Side)

Well No.

