

HAR.

M

3-11-61

W 146 307

WATER WELL DRILLERS LOG

M-329

Date: 3-11, 1961, Driller: C. J. Switzer Well Co County Farrison

(Name)

(1) Owner of Land:	Description & Color of Materials Sand, Clay, Red Clay, Shell, etc.	Thick- ness Feet	Depth Feet
<u>Roberts Hardy</u> (Name)	<u>Clay</u>	<u>0</u>	<u>20</u>
<u>Mt L Road, N. Biloxi, Miss</u> (Address)	<u>sand</u>	<u>20</u>	<u>40</u>
(2) Location: <u>1/4</u> , <u>1/4</u> , Sec. <u> </u> T <u> </u> k <u> </u>	<u>Clay + sand streaks</u>	<u>20</u>	<u>60</u>
<u> </u> miles <u> </u> of <u> </u>	<u>sand</u>	<u>10</u>	<u>70</u>
(distance) (direction) (Nearest Town)	<u>Clay</u>	<u>31</u>	<u>101</u>
(3) Topography: <u> </u> (Hilly) <u> </u> (Flat) <u> </u> (Level)	<u>sand</u>	<u>11</u>	<u>112</u>
<u> </u> (Hilly) <u> </u> (Flat) <u> </u> (Level)	<u>Clay</u>	<u>141</u>	<u>253</u>
(4) Purpose of Well: <u>Domestic</u>	<u>sand</u>	<u>40</u>	<u>293</u>
(Domestic Irrigation Municipal, Industrial, Other)			


Information upon completion of well:

- (1) Diameter 2 inches.
- (2) Total Depth 293 feet.
- (3) Water Level 6' feet below top of ground.
- (4) Cased to 293, Size 2"
- (5) Screen: Size 2", Length 10'
- (6) Were any formations sealed against pollution?
 yes, no.

If YES depth of formation 10 ft

Why Health Dept. Requirement

Drillers Remarks:

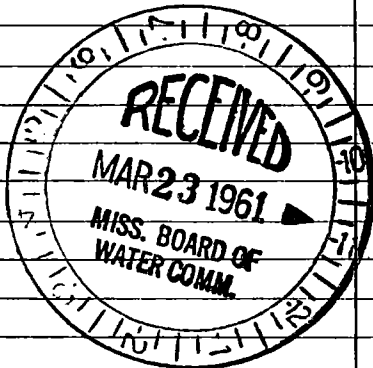

(Use Back Side)

Well No.

Handwritten text, possibly bleed-through from the reverse side of the page. The text is extremely faint and illegible due to the high contrast of the scan. It appears to be organized into several lines or paragraphs, but the specific words and numbers cannot be discerned.