

HAR.

M

3-7-61

WATER WELL DRILLERS LOG

M-331

Date: 3-7, 1961, Driller: C. F. Smitze Well Co County Harrison

(Name)

(1) Owner of Land: C. E. Lundy
 Cedar Lake Pky, Bogalusa, Miss
 (Name) (Address)

(2) Location: 1/4, 1/4, Sec. T R,
_____ miles, of _____
 (distance) (direction) (Nearest Town)

(3) Topography: (Hilly) (Flat) (Level)

(4) Purpose of Well: Domestic
 (Domestic Irrigation, Municipal, Industrial, Other)

Description & Color of Materials Sand, Clay, Red Clay, Shell, etc.	Thick- ness Feet	Depth Feet
Clay	0	8
Sand Gravel	14	22
Clay	20	42
Clay & sand streaks	20	62
Clay	121	183
Clay & sand streaks	21	204
Clay	101	305
Clay & shale	40	345
Clay	69	414
sand	56	470

Information upon completion of well:

(1) Diameter 2" inches.

(2) Total Depth 409 feet.

(3) Water Level 14 - feet below top of ground.

(4) Cased to 409, Size 2"


(5) Screen: Size 2", Length 10'

(6) Were any formations sealed against pollution?
 yes, _____ no.

If YES depth of formation 10 FT

Why Health Dept. Requirement

Drillers Remarks: _____

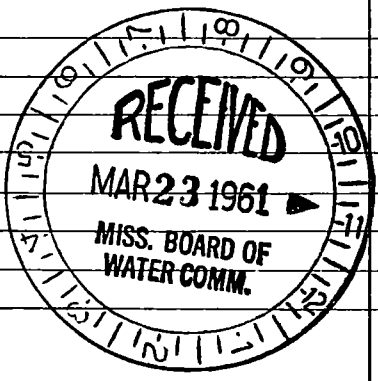

(Use Back Side)

Well No.

