

HAR,
M

WATER WELL DRILLERS LOG

2-13-61

Date: 2-13, 1961, Driller: C. E. Switzer Well Co County Harrison
(Name) M-336

(1) Owner of Land: Jessie Davis
(Name)

RT. 2 Box 485 Biloxi, Miss
(Address)

(2) Location: 1/4, 1/4, Sec. T k,
miles _____ of _____
(distance) (direction) (Nearest Town)

(3) Topography: (Hilly) (Flat) (Level)

(4) Purpose of Well: _____
(Domestic Irrigation, Municipal, Industrial, Other)

Description & Color of Materials Sand, Clay, Red Clay, Shell, etc.	Thick- ness Feet	Depth Feet
Clay	2	21
sand	30	51
Clay	92	143
sand	8	151
Clay	89	240
sand	3	243
Clay	121	264
sand	6	270
Clay	32	302
sand	3	303
Clay	17	320
sand	24	344

Information upon completion of well:

(1) Diameter 2 inches.

(2) Total Depth 344 feet.

(3) Water Level 1+ feet below top of ground.

(4) Cased to 344', Size 2"


(5) Screen: Size 2", Length 10 ft

(6) Were any formations sealed against pollution?
Yes, _____ no.

If YES depth of formation 10 ft

Why Health Dept Requirement

Drillers Remarks: _____

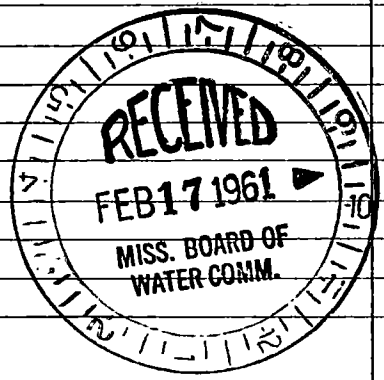

(Use Back Side)

Well No.

