

HAR.

M

WATER WELL DRILLERS LOG

M-337

2-8-61

Date: 2-8, 1961, Driller: C.T. Smitzger Well Co. County: Harrison

(Name)

(1) Owner of Land: EDWARD F. SARBELLA (Name)

St. Louis Ave., Biloxi, Miss. (Address)

(2) Location: 1/4, 1/4, Sec. T R

miles of (distance) (direction) (Nearest Town)

(3) Topography: (Hilly) (Flat) (Level)

(4) Purpose of Well: (Domestic Irrigation Municipal, Industrial, Other)

Information upon completion of well:


- (1) Diameter 2 inches.
(2) Total Depth 314 feet.
(3) Water Level 20- feet below top of ground.
(4) Cased to 314, Size 2 in.
(5) Screen: Size 2", Length 10 ft.
(6) Were any formations sealed against pollution? yes, no.

If YES depth of formation 10 ft.

Why Health Dept. Requirements

Drillers Remarks:

Table with 3 columns: Description & Color of Materials, Thickness Feet, Depth Feet. Rows include Sand, Clay, Good Sand, Fine Sand, and Sand.

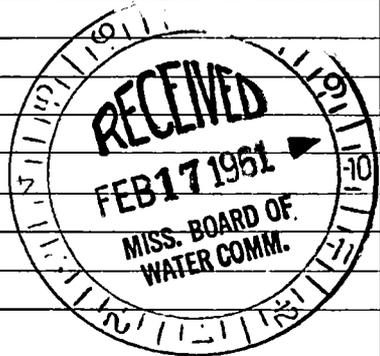

(Use Back Side)

Well No.

