

M

5-29-61

WATER WELL DRILLERS LOG

M-338

Date: May 29, 1961, Driller: Switzer Well Co County Harrison
 (Name)

(1) Owner of Land: Howard Hally Jr.
 (Name)
Ethel Ave, No Biloxi,
 (Address)

(2) Location: 1/4, 1/4, Sec. 79
79
 miles of
 (distance) (direction) (Nearest Town)

(3) Topography: X
 (Hilly) (Flat) (Level)

(4) Purpose of Well: Domestic
 (Domestic Irrigation
 Municipal, Industrial, Other)

Description & Color of Materials Sand, Clay, Red Clay, Shell, etc.	Thick- ness Feet	Depth Feet
clay	0	20
sand	20	38
clay	38	70
rock	70	71
clay	71	104
sand	104	128

Information upon completion of well:

(1) Diameter 2" inches.

(2) Total Depth 128 feet.

(3) Water Level 1 1/2' feet below top of ground.


(4) Cased to 128, Size 2"

(5) Screen: Size 2", Length 10'

(6) Were any formations sealed against pollution?
X yes, no.

If YES depth of formation _____
 Why Health Dept Requirement.

Drillers Remarks:

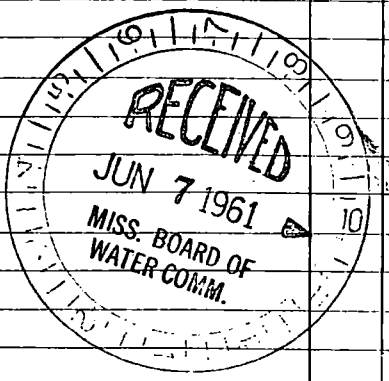

(Use Back Side)

Well No.

