

HAR.

MISSISSIPPI BOARD OF WATER COMMISSIONERS

M

8-23-61

WATER WELL DRILLERS LOG

M 300

349

Date: 8-23, 1961, Driller: Sutter Well Works County Harrison

(Name)

(1) Owner of Land: S. J. Cruthirds  
 (Name)  
Rt 1 Box 26 - Gulfport  
 (Address)

(2) Location: 1/4, 1/4, Sec.     T     R    ,  
    miles     W of Miss. City  
 (distance) (direction) (Nearest Town)

(3) Topography: Flat  
 (Hilly) (Flat) (Level)

(4) Purpose of Well: domestic  
 (Domestic Irrigation  
 Municipal, Industrial, Other)

Description & Color of Materials  
Sand, Clay, Red Clay, Shell, etc.

Thick-  
ness  
Feet

Depth  
Feet

Sand

106

106

Clay

114

220

Sand

21

241

Information upon completion of well:

(1) Diameter 2 inches.

(2) Total Depth 241 feet.

(3) Water Level 18 feet below top of ground.

(4) Cased to all, Size 2"


(5) Screen: Size 2", Length 10'

(6) Were any formations sealed against pollution?  
    yes,  no.

If YES depth of formation    

Why    

Drillers Remarks:    

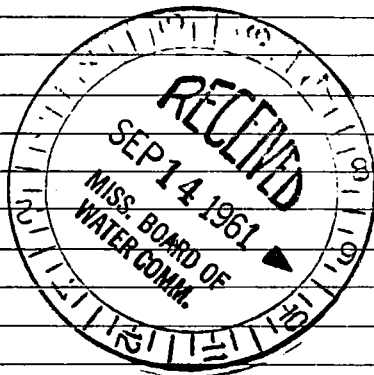

(Use Back Side)

Well No.

*[Faint, illegible text, possibly bleed-through from the reverse side of the page]*