

Harrison  
 N9  
 6-68

MISSISSIPPI  
 BOARD OF WATER COMMISSIONERS  
 416 North State Street  
 Jackson, Mississippi 39201

**CODED**

WATER WELL DRILLERS LOG

6-10 1968 Sutter Well Works Harrison  
 date well completed firm name county well located

LANDOWNER: Chief Natl. Bank  
Pass Christian,  
Miss.  
 (mailing address)

WELL LOCATION:  
 sec. 22 T. 8 N. R. 13 E.  
 (distance) (direction) (nearest town)  
0 miles N Pass Christian

WELL PURPOSE: Commercial  
 (home, irrigation, municipal, industrial)

- WELL COMPLETION DATA:
- (1) diameter (inches) 4 x 2 1/2
  - (2) total depth (feet) 834
  - (3) static water level (feet) 8 ~~below~~ above top of ground.
  - (4) casing Reb Steel 8 1/4"  
 (material) (depth)
  - 4" x 2 1/2" If telescope see back.  
 (size)
  - (5) screen 20', 8 1/4"  
 (length) (depth to top)
  - 2 1/2", Stainless Steel  
 (size) (material)
  - (6) pump 1 1/2 40  
 (HP) (yield gpm)
  - elec  
 (type power)
  - (7) electric log no  
 (yes or no)
  - (organization running log)
  - (8) how well bottom plugged BPU valve

description of formations encountered	from to	
sand	0	80
clay	80	194
sand	194	220
clay	220	248
sand	248	300
clay	300	333
sand	349	384
clay	384	790
sand	790	834

**CODED**

JUN 27 1968  
 MISS. BOARD OF  
 WATER COMMISSIONERS

DRILLERS REMARKS:


If well telescopes please sketch and show depths.

GROUND LEVEL

63' of 4" Leads

751' of 2 1/2" leads

20' of stainless  
Steel thinner  
2 1/2" size

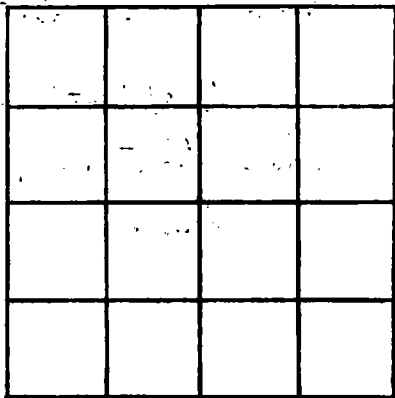

SECTION \_\_\_\_\_

Please indicate well location X.

ADDITIONAL INFORMATION

If more than one screen,  
show locations of each on sketch.