

CODED

MISSISSIPPI
BOARD OF WATER COMMISSIONERS
416 North State Street
Jackson, Mississippi 39201

WATER WELL DRILLERS LOG

Harrison
N 11
7-68

7-22 19 68 Sutter Well Works Harrison
 date well completed firm name county well located

LANDOWNER: Con-Plex, Inc.
Jackson, Miss

(mailing address)

WELL LOCATION:

sec. 5 T. 8 N. R. 13 E
 S W
 miles in Deale
 (distance) (direction) (nearest town)

WELL PURPOSE: industrial
 (home, irrigation, municipal, industrial)

WELL COMPLETION DATA:


- (1) diameter (inches) 2
- (2) total depth (feet) 254
- (3) static water level (feet) 12 below above top of ground.
- (4) casing galv 239'
 (material) (depth)
2" If telescope see back.
 (size)
- (5) screen 15' 239'
 (length) (depth to top)
2" Stainless Steel
 (size) (material)
- (6) pump 1 15
 (HP) (yield gpm)
elec
 (type power)
- (7) electric log no
 (yes or no)
- (organization running log)
- (8) how well bottom plugged B.P. Valve

description of formations encountered

from to

Clay	0	10
sand	10	87
Clay	87	213
sand	213	254

CODED

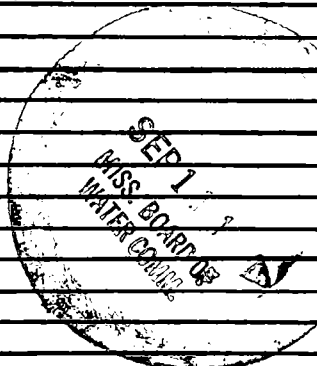

DRILLERS REMARKS:

If well telescopes please sketch and show depths.

GROUND LEVEL

01.0
02.0
03.0
04.0

01.0
02.0
03.0
04.0

		X	

SECTION 5

Please indicate well location X.

ADDITIONAL INFORMATION

Handwritten notes in the additional information section, including "PEE" and "1000".

If more than one screen, show locations of each on sketch.