

Harrison
 N 13
 7-68

MISSISSIPPI
 BOARD OF WATER COMMISSIONER
 416 North State Street
 Jackson, Mississippi 39201

CODED

WATER WELL DRILLERS LOG

7-3 1968 date well completed
 Sutter Well Works firm name
 Harrison county well located

LANDOWNER: Harry Smith
 Natchitoburg, Miss.
 (mailing address)

description of formations encountered	from	to
Clay	0	18
Sand	18	57
Clay	57	236
Sand	236	300


WELL LOCATION:
 sec. 17 T. 8 N R. 13 E
 S W
 1 1/2 miles N Pass Christian
 (distance) (direction) (nearest town)

WELL PURPOSE: home
 (home, irrigation, municipal, industrial)

- WELL COMPLETION DATA:
- (1) diameter (inches) 2
 - (2) total depth (feet) 300
 - (3) static water level (feet) 3 1/2 below top of ground.
 - (4) casing plastic, 290'
 (material) (depth)
2" If telescope see back.
 (size)
 - (5) screen 10', 290'
 (length) (depth to top)
2", plastic
 (size) (material)
 - (6) pump unknown
 (HP) (yield gpm)

CODED

- (type power)
- (7) electric log no
 (yes or no)
- (organization running log)
- (8) how well bottom plugged BP Value

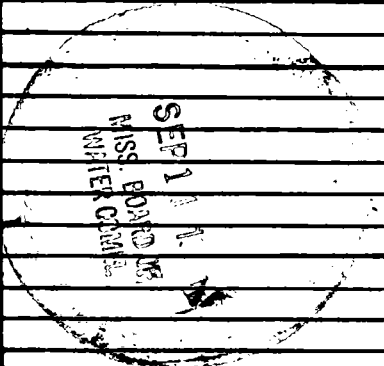

DRILLERS REMARKS:

If well telescopes please sketch and show depths.

GROUND LEVEL

		X	

SECTION 17

Please indicate well location X.

ADDITIONAL INFORMATION

If more than one screen, show locations of each on sketch.