

Harrison
 N 14
 6-28-68

MISSISSIPPI
 BOARD OF WATER COMMISSIONERS
 416 North State Street
 Jackson, Mississippi 39201

CODED

WATER WELL DRILLERS LOG

6-28-1968 date well completed
 Sutter Well Works firm name
 Harrison county well located

LANDOWNER: Justin Courtney
 Pass Christian, Miss.

Description of formations encountered	from to	
Sand	0	18
Clay	18	35
Sand	35	71


(mailing address)

WELL LOCATION:
 sec. 25 T-8 N R-13 E
 (distance) (direction) (nearest town)
 miles in of Sutter
 (distance) (direction) (nearest town)

WELL PURPOSE: irrigation
 (home, irrigation, municipal, industrial)

- WELL COMPLETION DATA:
- (1) diameter (inches) 2
 - (2) total depth (feet) 71
 - (3) static water level (feet) 15 below top of ground.
 - (4) casing galv. 66' (material) (depth)
 2" (size) If telescope see back.
 - (5) screen 5' 66' (length) (depth to top)
 2" (size) Stainless steel (material)
 - (6) pump unknown (HP) (yield gpm)
 (type power)
 - (7) electric log no (yes or no)
 (organization running log)
 - (8) how well bottom plugged B.P. Value

CODED

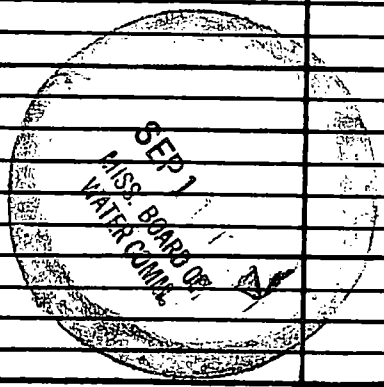

DRILLERS REMARKS: *[Handwritten marks]*

If well telescopes please sketch and show depths.

GROUND LEVEL

SECTION _____

Please indicate well location X.

ADDITIONAL INFORMATION

If more than one screen, show locations of each on sketch.