

Harrison
 N 15
 7-1-68

MISSISSIPPI
 BOARD OF WATER COMMISSIONERS
 416 North State Street
 Jackson, Mississippi 39201

CODED

WATER WELL DRILLERS LOG

7-1 1968 Sutter Well Works Harrison
 date well completed firm name county well located

LANDOWNER: Thos. Parolini

description of formations encountered	from	to

R. 1
 Pass Christian Miss.
 (mailing address)

Sand	0	87
Clay, Sand streak	87	305
Sand	305	320


WELL LOCATION:
 sec. 6 T. 8 R. 13
 S W
1 1/2 miles W of Delisle
 (distance) (direction) (nearest town)

WELL PURPOSE: Home
 (home, irrigation, municipal, industrial)

WELL COMPLETION DATA:

- (1) diameter (inches) 2
- (2) total depth (feet) 320
- (3) static water level (feet) 2 below above top of ground.
- (4) casing galv. 310'
 (material) (depth)
2"
 (size) If telescope see back.
- (5) screen 10' 310'
 (length) (depth to top)
2" stainless steel
 (size) (material)
- (6) pump Wabco
 (HP) (yield gpm)
 (type power)
- (7) electric log no
 (yes or no)
 (organization running log)
- (8) how well bottom plugged BP Value

CODED

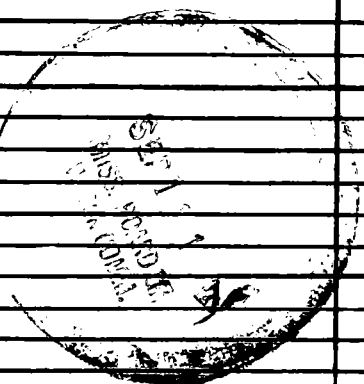

DRILLERS REMARKS:

If well telescopes please sketch and show depths.

GROUND LEVEL

	X		

SECTION 6

Please indicate well location X.

ADDITIONAL INFORMATION

If more than one screen, show locations of each on sketch.