

Harrison
 N 16
 7-23-68

MISSISSIPPI
 BOARD OF WATER COMMISSIONERS
 416 North State Street
 Jackson, Mississippi 39201

CODED

WATER WELL DRILLERS LOG

7-23 1968 date well completed
 Little Well Works firm name
 Harrison county well located

LANDOWNER: D.M. Ladner

DeLesle

Miss

(mailing address)

WELL LOCATION:

sec 5 T 8 N R 13
 S W
1 miles IN DeLesle of (distance) (direction) (nearest town)

WELL PURPOSE: home
 (home, irrigation, municipal, industrial)

WELL COMPLETION DATA:


- (1) diameter (inches) 2
- (2) total depth (feet) 258
- (3) static water level (feet) 2 1/2 ^{below} ~~above~~ top of ground.
- (4) casing galv., 248'
 (material) (depth)
2" if telescope see back.
 (size)
- (5) screen 10', 248'
 (length) (depth to top)
2", Stainless steel
 (size) (material)
- (6) pump unknown
 (HP) (yield gpm)
 (type power)
- (7) electric log no
 (yes or no)
 (organization running log)
- (8) how well bottom plugged B.P. Value

description of formations encountered

from to

Clay	0	10
sand	10	83
clay	83	189
sand	189	220
Clay	220	241
sand	241	258

CODED

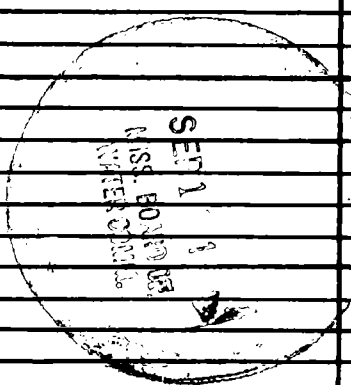

DRILLERS REMARKS:

If well telescopes please sketch and show depths.

GROUND LEVEL

0
5
10
15
20
25
30
35
40
45
50

Handwritten notes and sketches in the right column, including a vertical line extending from the ground level line.

		X	

SECTION 5

Please indicate well location X.

ADDITIONAL INFORMATION

Handwritten notes and data in the 'ADDITIONAL INFORMATION' section, including various numbers and text.

If more than one screen, show locations of each on sketch.