

**CODED**

MISSISSIPPI  
BOARD OF WATER COMMISSIONERS  
416 North State Street  
Jackson, Mississippi 39201

**WATER WELL DRILLERS LOG**

Harrison  
NIT  
8-6-68

8-6 1968 Sutter Well Washer Harrison  
date well completed firm name county well located

LANDOWNER: E. E. SMITH

description of formations encountered

from to

Pt. 1

Peer Christian Miss.  
(mailing address)

Clay  
sand  
Clay  
sand  
Clay

0 18  
18 78  
78 292  
292 336

WELL LOCATION:


sec 5 T 8 N R 13 S  
S W  
1 1/2 miles E of Delisle  
(distance) (direction) (nearest town)

WELL PURPOSE: home  
(home, irrigation, municipal, industrial)

WELL COMPLETION DATA:

- (1) diameter (inches) 2 ~~3~~
- (2) total depth (feet) 336
- (3) static water level (feet) 4 below  
top of ground. above
- (4) casing galv., 326'  
(material) (depth)  
2"  
(size) If telescope see back.
- (5) screen 10', 326'  
(length) (depth to top)  
2", stainless steel  
(size) (material)
- (6) pump unknown  
(HP) (yield gpm)  
  
(type power)
- (7) electric log no  
(yes or no)  
  
(organization running log)
- (8) how well bottom plugged BPU slud

**CODED**

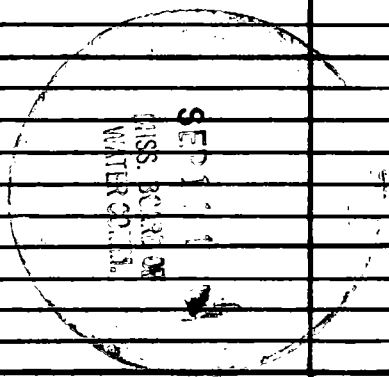

DRILLERS REMARKS:

If well telescopes please sketch and show depths.

GROUND LEVEL

11-11-11 13:30

12/13/11  
12/14/11  
12/15/11  
12/16/11  
12/17/11  
12/18/11  
12/19/11  
12/20/11  
12/21/11  
12/22/11  
12/23/11  
12/24/11  
12/25/11  
12/26/11  
12/27/11  
12/28/11  
12/29/11  
12/30/11  
12/31/11

12/13/11  
12/14/11  
12/15/11  
12/16/11  
12/17/11  
12/18/11  
12/19/11  
12/20/11  
12/21/11  
12/22/11  
12/23/11  
12/24/11  
12/25/11  
12/26/11  
12/27/11  
12/28/11  
12/29/11  
12/30/11  
12/31/11

	X		

SECTION 5

Please indicate well location X.

ADDITIONAL INFORMATION

12/13/11

12/14/11

12/15/11

12/16/11

12/17/11

12/18/11

12/19/11

12/20/11

12/21/11

12/22/11

12/23/11

12/24/11

12/25/11

12/26/11

12/27/11

12/28/11

12/29/11

12/30/11

12/31/11

If more than one screen, show locations of each on sketch.