

**CODED**

N 18  
10-21-61

**WATER WELL DRILLERS LOG**

Date: 10-21, 1961, Driller: L. Beall County Harrison  
(Name)

| (1) Owner of Land: <u>D. A. Marenilla</u><br>(Name)                                       | Description & Color of Materials<br>Sand, Clay, Red Clay, Shell, etc. | Thick-<br>ness<br>Feet | Depth<br>Feet |
|---|---|------------------------|---------------|
| <u>5346 Cameron Blvd No La</u><br>(Address)   | <u>Red Clay + sand</u>  | <u>20</u>              | <u>2.0</u>    |
| (2) Location: <u>NW 1/4, NW 1/4, Sec 26 T6 R13</u>  | <u>Soft Mud</u>   | <u>40</u>              | <u>6.0</u>    |
| <u>2 1/2</u> miles <u>East</u> of <u>Delisle</u><br>(distance) (direction) (Nearest Town) | <u>White Mud</u>  | <u>80</u>              | <u>14.0</u>   |
| (3) Topography: <u>X</u> (Hilly) (Flat) (Level)   | <u>Blue hard Clay</u>   | <u>120</u>             | <u>26.0</u>   |
| (4) Purpose of Well: <u>Home</u><br>(Domestic Irrigation<br>Municipal, Industrial, Other) | <u>Fine sand</u>  | <u>30</u>              | <u>29.0</u>   |
|   | <u>Hard Blue Mud</u>  | <u>80</u>              | <u>37.0</u>   |
|   | <u>Loose sand</u>   | <u>28</u>              | <u>39.8</u>   |


**Well CODED**

**398**

Information upon completion of well:

- (1) Diameter 2 1/4 inches.
- (2) Total Depth 398 feet.
- (3) Water Level 30 feet below top of ground.
- (4) Cased to \_\_\_\_\_, Size \_\_\_\_\_
- (5) Screen: Size 1/4, Length 10'
- (6) Were any formations sealed against pollution?  
\_\_\_\_\_ yes, \_\_\_\_\_ no.

If YES depth of formation \_\_\_\_\_  
Why \_\_\_\_\_  
Drillers Remarks: \_\_\_\_\_

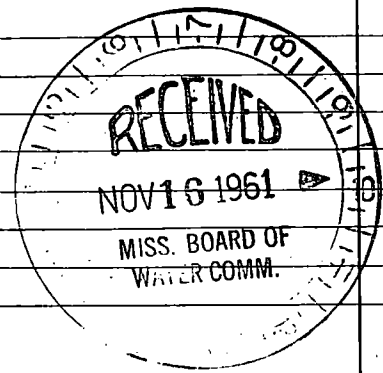

(Use Back Side)

Well No.



0000

11 12-31

100 1000000000

1