

HAR.

MISSISSIPPI BOARD OF WATER COMMISSIONERS

N 19

WATER WELL DRILLERS LOG

N-324

12-1-61

CODED

Date: 12-1, 1961, Driller: Sutter Well Works, Harrison

(Name)

(1) Owner of Land:	Description & Color of Materials Sand, Clay, Red Clay, Shell, etc.	Thick- ness Feet	Depth Feet
John Gavagnie (Name)	Surface sand	6	6
De Lisle Miss (Address)	sand + gravel	75	81
(2) Location: NE 1/4, SW 1/4, Sec. 4 T85 R134	Clay	364	445
_____ miles IN DELISLE (distance) (direction) (Nearest Town)	sand	45	490
(3) Topography: flat (Hilly) (Flat) (Level)	clay	32	522
(4) Purpose of Well: domestic (Domestic Irrigation Municipal, Industrial, Other)	sand	39	561

CODED


Information upon completion of well:

- (1) Diameter 2 inches.
- (2) Total Depth 561 feet.
- (3) Water Level 20 feet ^{above} below top of ground.
- (4) Cased to all, Size 2"
- (5) Screen: Size 2", Length 15'
- (6) Were any formations sealed against pollution?
 yes, no.

If YES depth of formation _____

Why _____

Drillers Remarks: _____

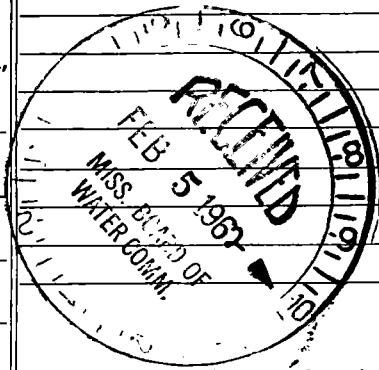

(Use Back Side)

Well No.

Handwritten text, likely bleed-through from the reverse side of the page. The text is extremely faint and illegible due to the high contrast and noise of the scan. Some faint words like "Handwritten" and "Text" are visible.