

HAR.

MISSISSIPPI BOARD OF WATER COMMISSIONERS

N 20
3-6-62

WATER WELL DRILLERS LOG

CODED

Date: 3-6, 1962, Driller: Jetter Well Works County: Harrison

(Name)

	Description & Color of Materials Sand, Clay, Red Clay, Shell, etc.	Thick- ness Feet	Depth Feet
(1) Owner of Land: <u>Mrs. C. M. Etheredge</u> (Name)	Clay	20	20
1806 E. Northside Dr. Jackson (Address)	Clay - sand streaks	28	48
(2) Location: <u>NE 1/4, SE 1/4, Sec. 38 T85R13, W</u> <u>1/2</u> miles <u>W</u> of <u>Pass Christian</u> (distance) (direction) (Nearest Town)	Sand	28	76
(3) Topography: <u>flat</u> (Hilly) (Flat) (Level)	CODED		
(4) Purpose of Well: <u>domestic</u> (Domestic Irrigation Municipal, Industrial, Other)			


Information upon completion of well:

- (1) Diameter 2 inches.
- (2) Total Depth 76 feet.
- (3) Water Level 8 feet below top of ground.
- (4) Cased to all, Size 2"
- (5) Screen: Size 2", Length 5'
- (6) Were any formations sealed against pollution?
no yes, no.

If YES depth of formation _____

Why _____

Drillers Remarks: _____

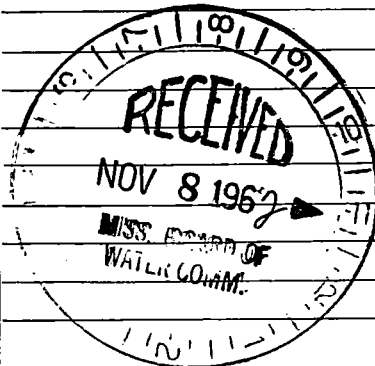

(Use Back Side)

Well No.

1880

1880
1881
1882
1896