

HAR.

MISSISSIPPI BOARD OF WATER COMMISSIONERS

N. 22  
7-19-62

WATER WELL DRILLERS LOG

**CODED**

Date: 7-19, 1962, Driller: Jetter Well Wash County Harrison  
(Name)

(1) Owner of Land: <u>Edw. Van Zandt</u> (Name)	Description & Color of Materials Sand, Clay, Red Clay, Shell, etc.	Thick- ness Feet	Depth Feet
<u>de Lisle</u> (Address)	<u>Surface Clay</u>	<u>10</u>	<u>10</u>
(2) Location: <u>NE 1/4, SE 1/4, Sec. 5 T. 8 R. 13 W</u>	<u>Sand</u>	<u>60</u>	<u>70</u>
_____ miles <u>IN</u> of <u>de Lisle</u> (distance) (direction) (Nearest Town)	<u>Clay</u>	<u>120</u>	<u>190</u>
(3) Topography: <u>Flat</u> (Hilly) (Flat) (Level)	<u>fine sand streaks</u>		
(4) Purpose of Well: <u>domestic</u> (Domestic Irrigation Municipal, Industrial, Other)	<u>and clay</u>	<u>115</u>	<u>305</u>
	<u>Clay</u>	<u>177</u>	<u>482</u>
	<u>sand</u>	<u>62</u>	<u>544</u>

Information upon completion of well:


- (1) Diameter 2 inches.
- (2) Total Depth 544 feet.
- (3) Water Level 20 feet above below top of ground.
- (4) Cased to all, Size 2"
- (5) Screen: Size 2", Length 10'
- (6) Were any formations sealed against pollution?  
\_\_\_\_\_ yes,  no.

If YES depth of formation \_\_\_\_\_

Why \_\_\_\_\_

Drillers Remarks: \_\_\_\_\_

**CODED**

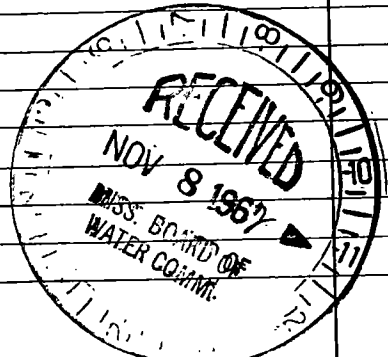

(Use Back Side)

Well No.

110

Handwritten header text, possibly a title or address, mostly illegible due to noise.

Main body of handwritten text, appearing to be a list or series of entries, with some numbers and words visible.

Continuation of handwritten text, showing more entries or details, with some faint lines and markings.

Bottom section of handwritten text, including what might be a signature or final notes, with some scattered characters.