

HAR
N 23
10-24-62

MISSISSIPPI BOARD OF WATER COMMISSIONERS

WATER WELL DRILLERS LOG

N
CODED

Date: 10-24, 1962, Driller: Sutton Well Works County Harrison
(Name)

(1) Owner of Land:	Description & Color of Materials Sand, Clay, Red Clay, Shell, etc.	Thick- ness Feet	Depth Feet
<u>G. J. Cambre</u> (Name)	<u>surface sand</u>	<u>25</u>	<u>25</u>
<u>Pass Christian, Miss.</u> (Address)	<u>clay</u>	<u>108</u>	<u>133</u>
(2) Location: <u>NE 1/4, SE 1/4, Sec. 38 T8S R13</u>	<u>sand & gravel</u>	<u>26</u>	<u>159</u>
<u>1</u> miles <u>W</u> of <u>Pass Christian</u> (distance) (direction) (Nearest Town)	<u>clay - sand streaks</u>	<u>306</u>	<u>465</u>
(3) Topography: <u>feet</u> (Hilly) (Flat) (Level)	<u>clay</u>	<u>145</u>	<u>610</u>
(4) Purpose of Well: <u>domestic</u> (Domestic Irrigation Municipal, Industrial, Other)	<u>sand streaks</u>	<u>180</u>	<u>790</u>
	<u>clay</u>	<u>213</u>	<u>903</u>
	<u>sand</u>	<u>81</u>	<u>984</u>

Information upon completion of well:


- (1) Diameter 2 inches.
- (2) Total Depth 984 feet.
- (3) Water Level 28 feet above below top of ground.
- (4) Cased to all, Size 2"
- (5) Screen: Size 2", Length 20'
- (6) Were any formations sealed against pollution?
no ✓

If YES depth of formation _____

Why _____

Drillers Remarks: _____

CODED

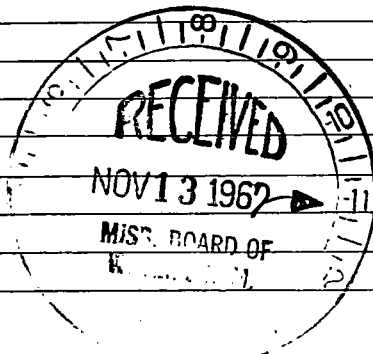

(Use Back Side)

Well No.

main body of text, mostly illegible due to heavy noise and low contrast.

at the bottom left, some faint text or a signature.

at the bottom center, some faint text or a signature.

at the bottom right, some faint text or a signature.