

CODED

WATER WELL DRILLERS LOG

HAR.
N. 25
11-19-62

Date: 11-19, 1962, Driller: Sutter Well Works County Harrison
(Name)

(1) Owner of Land: Louis Spier
(Name)
Pass Christian, Miss.
(Address)

(2) Location: SE 1/4, SE 1/4, Sec. 26 T85R13, W
1/2 miles N., of Pass Christian
(distance) (direction) (Nearest Town)

(3) Topography: flat
(Hilly) (Flat) (Level)

(4) Purpose of Well: domestic
(Domestic Irrigation
Municipal, Industrial, Other)

Description & Color of Materials Sand, Clay, Red Clay, Shell, etc.	Thick- ness Feet	Depth Feet
<u>Sand</u>	<u>20</u>	<u>20</u>
<u>Clay</u>	<u>140</u>	<u>160</u>
<u>Sand</u>	<u>20</u>	<u>180</u>
<u>Clay</u>	<u>90</u>	<u>270</u>
<u>Sand</u>	<u>30</u>	<u>300</u>
<u>Clay</u>	<u>22</u>	<u>322</u>
<u>sand</u>	<u>24</u>	<u>356</u>
<u>Clay</u>	<u>56</u>	<u>412</u>
<u>Sand</u>	<u>58</u>	<u>470</u>
<u>Clay - sand str.</u>	<u>290</u>	<u>760</u>
<u>Sand</u>	<u>90</u>	<u>850</u>

Information upon completion of well:

(1) Diameter 2 inches.

(2) Total Depth 850 feet.

(3) Water Level 25 feet above below top of ground.

(4) Cased to 600, Size 2"

(5) Screen: Size 2", Length 20'


(6) Were any formations sealed against pollution?
_____ yes, no.

CODED

If YES depth of formation _____

Why _____

Drillers Remarks: _____

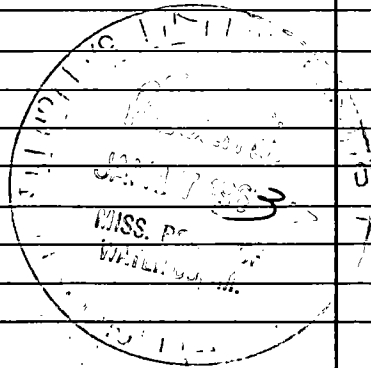

(Use Back Side)

Well No.

1880

1880

