

N 26
11-22-62

WATER WELL DRILLERS LOG

CODED K

Date: 11-22, 1962, Driller: Sutter Well Works County Harrison
(Name)


- (1) Owner of Land: Nezer Jones
(Name)
Rt. 1 Pass Christian, Miss.
(Address)
- (2) Location: NE 1/4, NE 1/4, Sec. 6 T. 25. R. 13 W
1 1/2 miles W of De Lisle
(distance) (direction) (Nearest Town)
- (3) Topography: to Lilly
(Hilly) (Flat) (Level)
- (4) Purpose of Well: domestic
(Domestic Irrigation
Municipal, Industrial, Other)

Description & Color of Materials Sand, Clay, Red Clay, Shell, etc.	Thick- ness Feet	Depth Feet
Clay	15	15
sand	77	92
Clay	98	190
sand	60	250
Clay	52	302
sand	13	315
Clay - sand streak	170	485
sand	40	525
Clay	75	600
sand	22	622
Clay	23	645
sand	77	722

Information upon completion of well:

- (1) Diameter 2 inches.
- (2) Total Depth 722 feet.
- (3) Water Level 16 feet above below top of ground.
- (4) Cased to all, Size 2"
- (5) Screen: Size 2", Length 20'
- (6) Were any formations sealed against pollution?
no

CODED

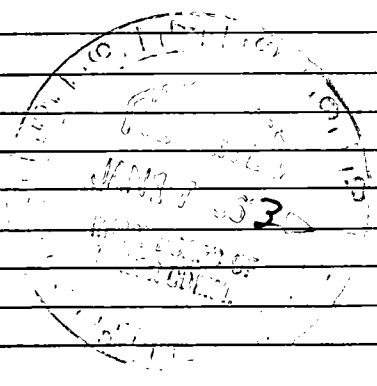

If YES depth of formation _____
Why _____
Drillers Remarks: _____

(Use Back Side)

Well No.

