

N 29
5-17-63

WATER WELL DRILLERS LOG

CODED

Date: 5-17, 1963, Driller: Sutter Well Works County Harrison

(Name)

(1) Owner of Land: Geo. Bertucci
(Name)
Rt. 1 Pass Christian
(Address)

(2) Location: SW 1/4, SE 1/4, Sec. 17 T85R13W

2 miles N of P.C.
(distance) (direction) (Nearest Town)

(3) Topography: flat
(Hilly) (Flat) (Level)

(4) Purpose of Well: domestic
(Domestic Irrigation
Municipal, Industrial, Other)

Description & Color of Materials Sand, Clay, Red Clay, Shell, etc.	Thick- ness Feet	Depth Feet
Clay	24	24
sand	18	42
Clay	195	237
sand	15	252
Clay/sandstone	42	294
Coarse sand	7	301

Information upon completion of well:

CODED

(1) Diameter 2 inches.

(2) Total Depth 301 feet.

(3) Water Level 3 feet above below top of ground.

(4) Cased to all, Size 2"


(5) Screen: Size 2", Length 5'

(6) Were any formations sealed against pollution?
yes, no.

If YES depth of formation _____

Why _____

Drillers Remarks: _____

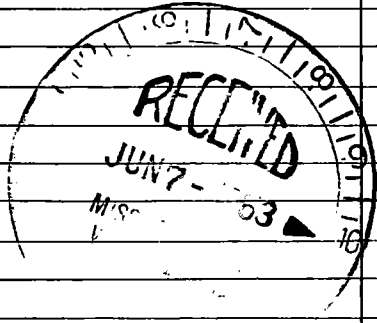

(Use Back Side)

Well No.

