

N 30

5-22-63

WATER WELL DRILLERS LOG

CODED

Date: 5-22, 1963, Driller: Sutter Well Works County Harrison
(Name)

(1) Owner of Land: L C Ezell
(Name)
Long Beach Miss.
(Address)

(2) Location: 1/4, 1/4, Sec. 5 T. R.
 miles in , of De Lisle
(distance) (direction) (Nearest Town)

(3) Topography: Hilly
(Hilly) (Flat) (Level)

(4) Purpose of Well: domestic
(Domestic Irrigation
Municipal, Industrial, Other)

Description & Color of Materials Sand, Clay, Red Clay, Shell, etc.	Thick- ness Feet	Depth Feet
Clay	15	15
Sand	51	66
Clay	162	228
sand	20	248

Information upon completion of well:

(1) Diameter 2 inches.

(2) Total Depth 248 feet.

(3) Water Level 3 feet below top of ground.

(4) Cased to all, Size 2"

(5) Screen: Size 2", Length 5'


(6) Were any formations sealed against pollution?
 yes, no.

If YES depth of formation

Why

Drillers Remarks:

CODED

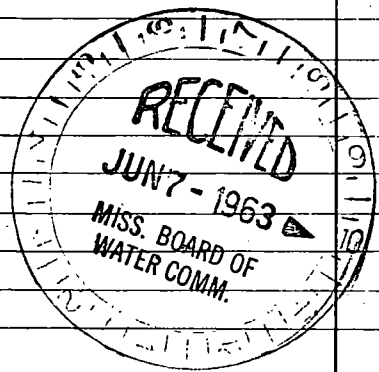

(Use Back Side)

Well No.

0000

...

...

