

N 31

6-10-63

WATER WELL DRILLERS LOG

CODED

Date: 6-10, 1963, Driller: Sutter Well Works County Harrison

(Name)

(1) Owner of Land: Crosby Forest Products
 (Name)
Picayune, Miss.
 (Address)

(2) Location: SW 1/4, SW 1/4, Sec. 9 T8S R13, W
4 miles W of Idle Lake
 (distance) (direction) (Nearest Town)

(3) Topography: hilly
 (Hilly) (Flat) (Level)

(4) Purpose of Well: domestic
 (Domestic Irrigation
 Municipal, Industrial, Other)

Description & Color of Materials Sand, Clay, Red Clay, Shell, etc.	Thick- ness Feet	Depth Feet
Mud, Clay & Sand	70	70
Clay	276	346
Sand	74	420
Clay	234	654
Sand	68	715

Information upon completion of well:

(1) Diameter 2 inches.

(2) Total Depth 715 feet.

(3) Water Level 33 feet above below top of ground.

(4) Cased to all, Size 2"

(5) Screen: Size 2", Length 20'


(6) Were any formations sealed against pollution?
 _____ yes, no.

CODED

If YES depth of formation _____

Why _____

Drillers Remarks: _____

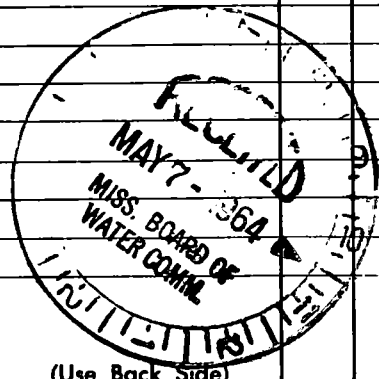

(Use Back Side)

Well No.

0000

Faint, illegible text scattered across the upper half of the page, possibly bleed-through from the reverse side.

Small, illegible mark or stamp on the left side of the page.

Faint, illegible text in the lower right quadrant of the page.