

HAR.
N 32
6-21-63

MISSISSIPPI BOARD OF WATER COMMISSIONERS

WATER WELL DRILLERS LOG

CODED ^{H13}

Date: 6-21, 1963, Driller: Sutter Wood Works County Harrison

(Name)

(1) Owner of Land: John A. Becker
(Name)

Pass Christian
(Address)

(2) Location: SE 1/4, SE 1/4, Sec. 32 T8SR 13, W

1 miles W of Pass Christian
(distance) (direction) (Nearest Town)

(3) Topography: flat
(Hilly) (Flat) (Level)

(4) Purpose of Well: Industrial
(Domestic Irrigation
Municipal, Industrial, Other)

Description & Color of Materials
Sand, Clay, Red Clay, Shell, etc.

Thick-
ness
Feet

Depth
Feet

sand

15

15

clay

17

32

mud + sand

136

168

sand

30

198

Information upon completion of well:

(1) Diameter: 2 inches.

(2) Total Depth: 198 feet.

(3) Water Level: 6 feet below top of ground.

(4) Cased to: all, Size: 2"

(5) Screen: Size: 2", Length: 5'

(6) Were any formations sealed against pollution?


no

If YES depth of formation _____

Why _____

Drillers Remarks: _____

CODED

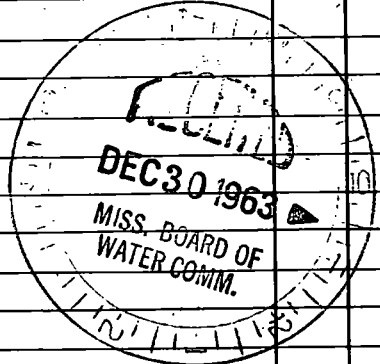

Well No.

(Use Back Side)

00000

... ..

... ..

