

N 33
7-15-63

WATER WELL DRILLERS LOG

CODED

Date: 7-15, 1963, Driller: Little Well Works County Harrison
(Name)

(1) Owner of Land: C.M. DOISEAU
(Name)
PASS CHRISTIAN
(Address)

(2) Location: SE 1/4, SE 1/4, Sec. 32 T8S R 13, W
1 miles W, of P.C.
(distance) (direction) (Nearest Town)

(3) Topography: flat
(Hilly) (Flat) (Level)

(4) Purpose of Well: domestic
(Domestic Irrigation, Municipal, Industrial, Other)

Description & Color of Materials Sand, Clay, Red Clay, Shell, etc.	Thick- ness Feet	Depth Feet
gravel <u>gravel</u>	116	116
<u>clay</u>	64	180
<u>sandy clay</u>	110	290
<u>clay</u>	50	340
<u>sand</u>	76	416
<u>clay</u>	431	847
<u>sand</u>	18	865
<u>clay</u>	35	900
<u>sand</u>	37	937

Information upon completion of well:

(1) Diameter 2 inches.

(2) Total Depth 937 feet.

(3) Water Level 25 feet above below top of ground.

(4) Cased to cell, Size 2"

(5) Screen: Size 2", Length 16'

(6) Were any formations sealed against pollution?
no yes, no.

NO Red now blown away with running annular 1969
Headless font


CODED

Drp 1/25/73

If YES depth of formation _____

Why _____

Drillers Remarks: _____

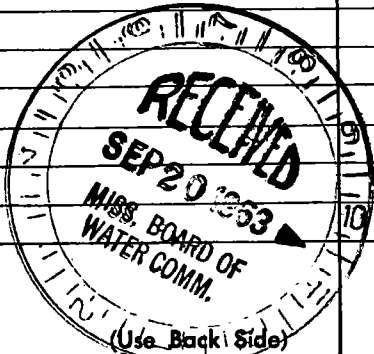

Well No.

1914

1000

1000

