

N 34
7-28-63

WATER WELL DRILLERS LOG

CODED

Date: 7-28, 1963, Driller: Jutter Well Works County Harrison
(Name)

(1) Owner of Land: Carnel W. Allen
(Name)
Pass Christian, Miss.
(Address)

(2) Location: SW 1/4, NE 1/4, Sec. 15 T85R13W
2 miles W, of Cuevas
(distance) (direction) (Nearest Town)

(3) Topography: flat
(Hilly) (Flat) (Level)

(4) Purpose of Well: domestic
(Domestic Irrigation
Municipal, Industrial, Other)

Description & Color of Materials Sand, Clay, Red Clay, Shell, etc.	Thick- ness Feet	Depth Feet
Clay	28	28
sand	67	95
Clay	72	167
sand	22	189
Clay	13	202
sand	18	220
Clay	27	247
sand	14	261
Clay	136	397
sand	53	450
Clay	48	498
Clay / sand streaks	27	525
sand	70	595
Clay	146	741
sand	148	889

Information upon completion of well:

(1) Diameter 2 inches.

(2) Total Depth 819 feet.

(3) Water Level 21 feet above below top of ground.

(4) Cased to all, Size 2"


(5) Screen: Size 2", Length 20'

(6) Were any formations sealed against pollution?
yes, no.

If YES depth of formation _____

Why _____

Drillers Remarks: _____

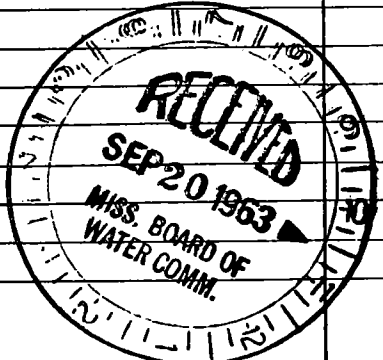

(Use Back Side)

Well No.

1944

1944

