

N 36

CODED

2-10-64

WATER WELL DRILLERS LOG

Date: 2-10, 1964, Driller: Butter Well Works County Harrison
 (Name)

(1) Owner of Land: Miriam Scheuermann
 (Name)
New Orleans La.
 (Address)

(2) Location: NE 1/4, NW 1/4, Sec. 38 T 85R 13W
1 miles W of Paso Christian
 (distance) (direction) (Nearest Town)

(3) Topography: flat
 (Hilly) (Flat) (Level)

(4) Purpose of Well: domestic
 (Domestic Irrigation
 Municipal, Industrial, Other)

Description & Color of Materials Sand, Clay, Red Clay, Shell, etc.	Thick- ness Feet	Depth Feet
Clay	40	40
sand	10	50
clay	130	180
red sand - gravel	40	220
clay	90	310
sand	36	346


Information upon completion of well:

- (1) Diameter 2 inches.
 (2) Total Depth 346 feet.
 (3) Water Level 1/2 feet above top of ground.
 (4) Cased to all, Size 2"
 (5) Screen: Size 2", Length 10'
 (6) Were any formations sealed against pollution?
 yes, no.

If YES depth of formation surface
 Why owner's request

Drillers Remarks:

CODED

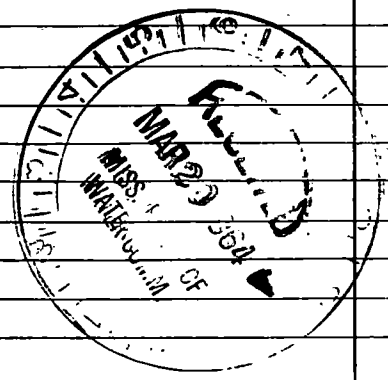

(Use Back Side)

Well No.

0300

0300

