

N 37

4-6-64

WATER WELL DRILLERS LOG

CODED

Date: 4-6, 1964, Driller: Butter Well Works County Harrison
 (Name)

(1) Owner of Land: Ferrest Parolin
 (Name)
46 Lisle Miss.
 (Address)

(2) Location: NW 1/4, NW 1/4, Sec. 3 T85R134
1/4 miles W, of Lisle
 (distance) (direction) (Nearest Town)

(3) Topography: hilly
 (Hilly) (Flat) (Level)

(4) Purpose of Well: domestic
 (Domestic Irrigation
 Municipal, Industrial, Other)

Description & Color of Materials Sand, Clay, Red Clay, Shell, etc.	Thick- ness Feet	Depth Feet
Clay	17	17
sand	36	53
Clay	17	70
Red Sand	48	118
clay	82	200
Sand	49	249

Information upon completion of well:

(1) Diameter 2 inches.

(2) Total Depth 249 feet.

(3) Water Level 2 feet below top of ground.

(4) Cased to all, Size 2"

(5) Screen: Size 2", Length 5'


(6) Were any formations sealed against pollution?
no yes, no.

If YES depth of formation _____

Why _____

Drillers Remarks: _____

CODED

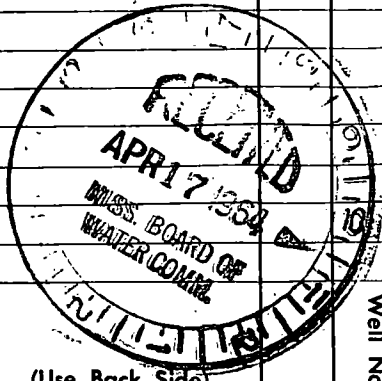

(Use Back Side)

Well No. _____

0000

1944

1944

