

N3

4-8-64

WATER WELL DRILLERS LOG

CODED

Date: 4-8, 1964, Driller: Sutter Well Works County Harrison
 (Name)

(1) Owner of Land: Farrest Paulini
 (Name)
de Lisle Miss.
 (Address)

(2) Location: NW 1/4, NW 1/4, Sec. 3 T85R13, W
1/4 miles W, of de Lisle
 (distance) (direction) (Nearest Town)

(3) Topography: hilly
 (Hilly) (Flat) (Level)

(4) Purpose of Well: domestic
 (Domestic Irrigation
 Municipal, Industrial, Other)

Description & Color of Materials Sand, Clay, Red Clay, Shell, etc.	Thick- ness Feet	Depth Feet
Clay	18	18
Sand	32	50
Clay	20	70
Sand	45	115
Clay	80	195
Sand	41	236

Information upon completion of well:

(1) Diameter 2 inches.

(2) Total Depth 236 feet.

(3) Water Level 2 feet below top of ground.

(4) Cased to see, Size 2"

(5) Screen: Size 2", Length 5


(6) Were any formations sealed against pollution?
no yes, no.

CODED

If YES depth of formation _____

Why _____

Drillers Remarks: _____

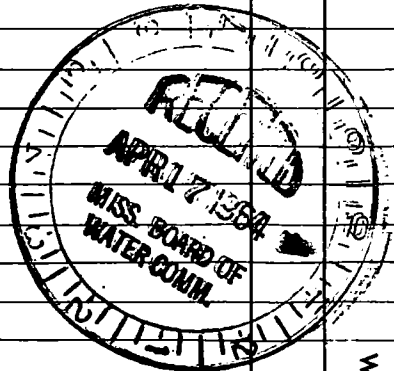

(Use Back Side)

Well No.

1930

1930
1931
1932
1933
1934
1935
1936
1937
1938
1939
1940

1930
1931
1932
1933
1934
1935
1936
1937
1938
1939
1940

1930

1930
1931
1932
1933
1934
1935
1936
1937
1938
1939
1940

1930
1931
1932
1933
1934
1935
1936
1937
1938
1939
1940