

N 39
4-10-64

WATER WELL DRILLERS LOG

CODED

Date: 4-10, 1964, Driller: Sutter Well Works County Harrison
(Name)

(1) Owner of Land: Odell Heideauf
(Name)
de Lisle, Miss.
(Address)

(2) Location: NW 1/4, NW 1/4, Sec. 3 T8S R13, W
_____ miles _____ in _____
(distance) (direction) (Nearest Town)

(3) Topography: hilly
(Hilly) (Flat) (Level)

(4) Purpose of Well: domestic
(Domestic Irrigation
Municipal, Industrial, Other)

Description & Color of Materials Sand, Clay, Red Clay, Shell, etc.	Thick- ness Feet	Depth Feet
Clay	18	18
sand	11	29
Clay	36	65
sand	13	78
Clay	122	200
sand	25	225

CODED

Information upon completion of well:

(1) Diameter 2 inches.

(2) Total Depth 225 feet.

(3) Water Level 4 feet below top of ground.

(4) Cased to all, Size 2"


(5) Screen: Size 2", Length 5'

(6) Were any formations sealed against pollution?
_____ yes, no.

If YES depth of formation _____

Why _____

Drillers Remarks: _____

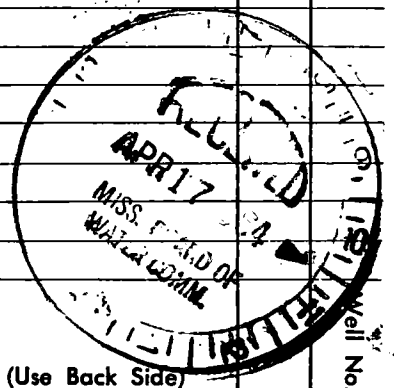

(Use Back Side)

1910

Handwritten notes, possibly a list or ledger, with illegible entries.

1911

Main body of handwritten notes or a ledger, containing multiple lines of illegible text.