

HAR.

MISSISSIPPI BOARD OF WATER COMMISSIONERS

N 40

5-18-64

WATER WELL DRILLERS LOG

CODED

Date: 5-18, 1964, Driller: Suttler Well Works County Harrison

(Name)

(1) Owner of Land: Mrs. E.H. Schize
(Name)
4312 S. Claiborne N.O. La.
(Address)

Description & Color of Materials
Sand, Clay, Red Clay, Shell, etc.

Thick-
ness
Feet

Depth
Feet

Clay 162 162
sand 15 177

(2) Location: SW 1/4, SE 1/4, Sec 32 T85R13W

1 miles W of Paris Christian
(distance) (direction) (Nearest Town)

(3) Topography: flat
(Hilly) (Flat) (Level)

(4) Purpose of Well: domestic
(Domestic Irrigation
Municipal, Industrial, Other)

CODED

Information upon completion of well:


- (1) Diameter 2 inches.
- (2) Total Depth 177 feet.
- (3) Water Level 1 feet above below top of ground.
- (4) Cased to all, Size 2"
- (5) Screen: Size 2", Length 5'
- (6) Were any formations sealed against pollution?

yes, no.

If YES depth of formation

Why

Drillers Remarks:

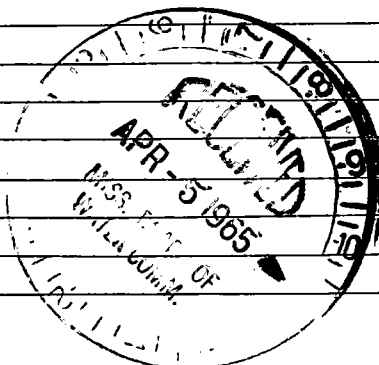

(Use Back Side)

Well No.

1930

... ..

...

...

