

HAR. N 41
1-6-65

MISSISSIPPI BOARD OF WATER COMMISSIONERS

CODED

WATER WELL DRILLERS LOG

Date: 1-6, 1965, Driller: Sutter Well Works County Harrison
(Name)

(1) Owner of Land: Reed Winstead
(Name)
Pass Christian, Miss
(Address)

(2) Location: NE 1/4, SW 1/4, Sec. 4 T8S R13, W
miles in of Delisle,
(distance) (direction) (Nearest Town)

(3) Topography: flat
(Hilly) (Flat) (Level)

(4) Purpose of Well: domestic
(Domestic Irrigation
Municipal, Industrial, Other)

Description & Color of Materials Sand, Clay, Red Clay, Shell, etc.	Thick- ness Feet	Depth Feet
Clay	20	20
Sand	98	118
Clay	103	221
Sand	39	260
Clay	67	327
Sand	32	359
Clay	81	440
Sand	34	474
Clay	22	496
Sand	41	537

Information upon completion of well:

(1) Diameter 2 inches.

(2) Total Depth 537 feet.

(3) Water Level 19 feet Above below top of ground.

(4) Cased to all, Size 2"

(5) Screen: Size 2", Length 16'


(6) Were any formations sealed against pollution?
 yes, no.

If YES depth of formation Surface

Why _____

Drillers Remarks: _____

CODED

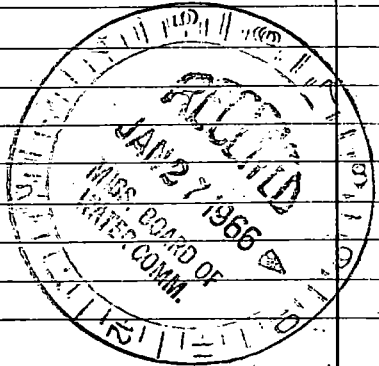

(Use Back Side)

Well No.

