

HARRISON
N44
3-3-72

MISSISSIPPI
BOARD OF WATER COMMISSIONERS
416 North State Street
Jackson, Mississippi 39201

CODED

WATER WELL DRILLERS LOG

Mar 3 1972 Finville water well Harrison
date well completed firm name county well located

LANDOWNER: Don Mitchell
Delisle

description of formations encountered	depth	
	from	to
<u>red clay</u>	<u>0</u>	<u>70</u>
<u>red sand & gravel</u>	<u>70</u>	<u>90</u>
<u>white clay</u>	<u>90</u>	<u>210</u>
<u>hard water</u>	<u>210</u>	<u>235</u>
<u>blue grey clay</u>	<u>235</u>	<u>505</u>
<u>hard water</u>	<u>505</u>	<u>570</u>

(mailing address)

WELL LOCATION:
sec 5 T 8 R 13
00 miles 0 of Delisle
(distance) (direction) (nearest town)

WELL PURPOSE:
(home, irrigation, municipal, industrial)

WELL COMPLETION DATA:

- (1) diameter (inches) 2"
- (2) total depth (feet) 570
- (3) static water level (feet) 22' below above top of ground.
- (4) casing PVC 570
(material) (depth)
 If telescope see back.
(size)
- (5) screen 15 555
(length) (depth to top)
2" PVC
(size) (material)
- (6) pump N/A N/A
(HP) (yield gpm)
N/A
(type power)
- (7) electric log N/A
(yes/or no)
N/A
(organization running log)
- (8) how well bottom plugged Sand
shank

CODED


MAY 25 1972

DRILLERS REMARKS:

MISS. Bd. of
WATER COM.

If well telescopes please sketch and show depths.

GROUND LEVEL

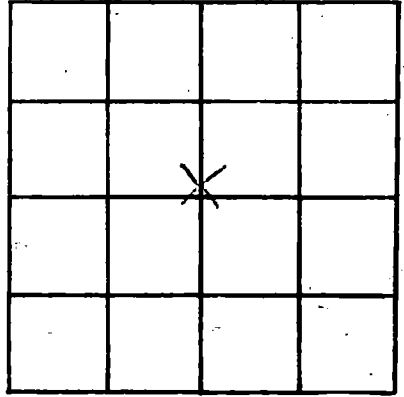

SECTION _____

Please indicate well location X.

ADDITIONAL INFORMATION

If more than one screen, show locations of each on sketch.