

N 45
7-2-65

WATER WELL DRILLERS LOG

CODED

Date: 7-2, 1965, Driller: Sutton Well Wks. County Harrison
(Name)

(1) Owner of Land: Mary C. Ward
(Name)
Pass Christian, Miss.
(Address)

(2) Location: S 1/4, SE 1/4, Sec. 26 T8S R 13 W
1 miles N of PC
(distance) (direction) (Nearest Town)

(3) Topography: flat
(Hilly) (flat) (Level)

(4) Purpose of Well: domestic
(Domestic Irrigation
Municipal, Industrial, Other)

Description & Color of Materials Sand, Clay, Red Clay, Shell, etc.	Thick- ness Feet	Depth Feet
<u>Randy Clay</u>	<u>41</u>	<u>41</u>
<u>sand</u>	<u>19</u>	<u>60</u>
<u>Clay</u>	<u>52</u>	<u>112</u>
<u>sand</u>	<u>27</u>	<u>139</u>
<u>Clay</u>	<u>28</u>	<u>267</u>
<u>sand</u>	<u>9</u>	<u>276</u>
<u>Clay</u>	<u>159</u>	<u>435</u>
<u>fine sand</u>	<u>9</u>	<u>444</u>
<u>Clay</u>	<u>18</u>	<u>462</u>
<u>sand</u>	<u>12</u>	<u>474</u>

Information upon completion of well:

(1) Diameter 2 inches.

(2) Total Depth 474 feet.

(3) Water Level 1/2 feet ABOVE below top of ground.

(4) Cased to see, Size 2"

(5) Screen: Size 2", Length 10'


(6) Were any formations sealed against pollution?
no

CODED

If YES depth of formation _____

Why _____

Drillers Remarks: _____

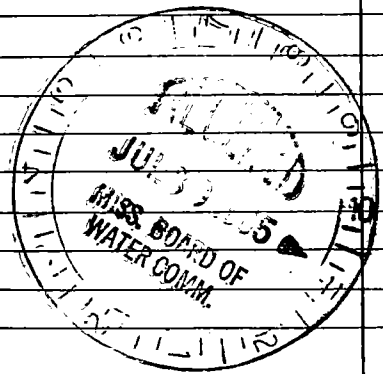

(Use Back Side)

Well No. _____

0200

1941 1942 1943 1944 1945 1946 1947 1948 1949 1950

1941
1942
1943
1944
1945
1946
1947
1948
1949
1950

1941
1942
1943
1944
1945
1946
1947
1948
1949
1950

1941
1942
1943
1944
1945
1946
1947
1948
1949
1950