

N 46  
11-29-65

WATER WELL DRILLERS LOG

**CODED**

Date: 11-29, 1965, Driller: Little Well Works County Harrison  
(Name)

(1) Owner of Land: Sam Bases  
(Name)  
Pass Christian, Miss.  
(Address)

(2) Location: NE 1/4, NE 1/4, Sec: 38 T8S R13E  
1 miles W of Pass Christian  
(distance) (direction) (Nearest Town)

(3) Topography: flat  
(Hilly) (Flat) (Level)

(4) Purpose of Well: domestic  
(Domestic Irrigation  
Municipal, Industrial, Other)

Description & Color of Materials Sand, Clay, Red Clay, Shell, etc.	Thick- ness Feet	Depth Feet
Clay	33	33
Sand	16	49
Clay	97	146
Sand + gravel	34	180
Clay	21	201
Sand	11	212
Clay	51	263
Sand	19	282
Clay	41	323
Sand	44	367

Information upon completion of well:

(1) Diameter 2 inches.

(2) Total Depth 367 feet.

(3) Water Level 1 <sup>above</sup> feet ~~below~~ top of ground.

(4) Cased to all, Size 2"

(5) Screen: Size 2", Length 10'


(6) Were any formations sealed against pollution?  
no

**CODED**

If YES depth of formation \_\_\_\_\_

Why \_\_\_\_\_

Drillers Remarks: \_\_\_\_\_

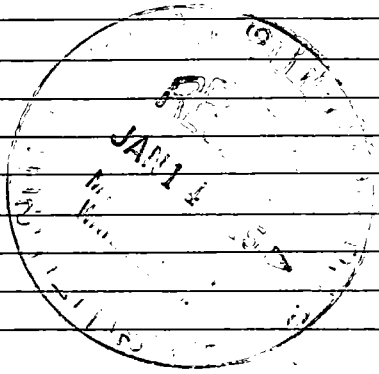

(Use Back Side)

Well No.

Handwritten text at the top of the page, possibly a title or header, which is mostly illegible due to fading and noise.

Main body of handwritten text, appearing to be a list or series of entries. The text is very faint and difficult to decipher.

Continuation of the handwritten text, showing some structural elements like lines and possibly a table or organized list.

Bottom section of the page with handwritten text, including what might be a signature or a final note.