

HAR. N 47  
3-2-66

MISSISSIPPI BOARD OF WATER COMMISSIONERS

WATER WELL DRILLERS LOG

**CODED**

Date: 3-2, 1966, Driller: Sutton Well Works County Harrison  
(Name)

(1) Owner of Land: Col. R. J. Platt  
(Name)  
Pass Christian, Miss.  
(Address)

(2) Location: SW 1/4, NE 1/4, Sec. 30 T8R13W  
1 miles W Pass Christian  
(distance) (direction) (Nearest Town)

(3) Topography: flat  
(Hilly) (Flat) (Level)

(4) Purpose of Well: domestic  
(Domestic Irrigation  
Municipal, Industrial, Other)

Description & Color of Materials Sand, Clay, Red Clay, Shell, etc.	Thick- ness Feet	Depth Feet
Clay & Sandy Clay	40	40
Sand	15	55
Clay	71	126
Sand - gravel	61	187
Clay	65	252
Sand	31	283
Clay	43	326
Sand	52	378
Clay	265	643
Sand	19	662
Clay	113	775
Sand	48	823
Clay	87	910
Sand	80	990

Information upon completion of well:

(1) Diameter 2 inches.

(2) Total Depth 990 feet.

(3) Water Level 25 feet <sup>Above</sup> below top of ground.

(4) Cased to all, Size 2"

(5) Screen: Size 2", Length 20'


(6) Were any formations sealed against pollution?  
 yes,  no.

If YES depth of formation Surface

Why \_\_\_\_\_

Drillers Remarks: \_\_\_\_\_

**CODED**

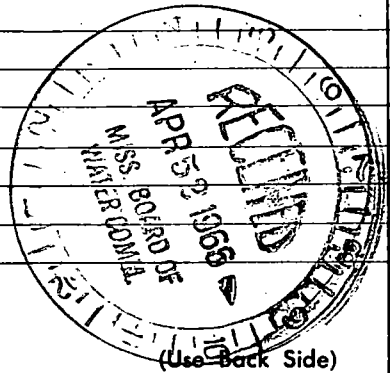

Well No. \_\_\_\_\_



Faint header text, possibly containing a date or reference number.

Handwritten text, possibly a name or title.

Main body of handwritten text, appearing as a list or series of notes.

off

side

at

"..."

"..."

Handwritten signature or name at the bottom of the page.