

HAR.

N52

MISSISSIPPI BOARD OF WATER COMMISSIONERS

CODED

4-21-66

WATER WELL DRILLERS LOG

Date: 4-21, 1966, Driller: Sutton Well Works County Harrison

(When well drilled)

(Name)

(Where well is located)

(1) Owner of Land: A. E. Fleaseller
(Name)

Poss Christian
(Address)

(2) Location: NW 1/4, NE 1/4, Sec 30 T. 8 R. 13 W

1 miles W Poss Christian
(distance) (direction) (Nearest Town)

(3) Topography: flat
(Hilly) (Flat) (Level)

(4) Purpose of Well: domestic
(Domestic Irrigation
Municipal, Industrial, Other)

Description & Color of Materials
Sand, Clay, Red Clay, Shell, etc.

Thick-
ness
Feet

Depth
Feet

Sand	8	3
Clay	25	93
sand	19	52
Clay	14	198
sand	17	215
Clay - sand streaks	206	421
sand	27	448
Clay - sand streaks	201	649
sand	11	660
Clay	116	776
sand	64	840
Clay	75	915
sand	66	981

Information upon completion of well:

- (1) Diameter 2 inches.
- (2) Total Depth 981 feet.
- (3) Water Level 25 feet above top of ground.
- (4) Cased to all, Size 2"
- (5) Screen: Size 2", Length 20'
- (6) Were any formations sealed against pollution?

yes, no.

If YES depth of formation surface

Why _____


Drillers Remarks: _____

Yield in gpm: _____

Size pump: _____

Type power: _____

CODED

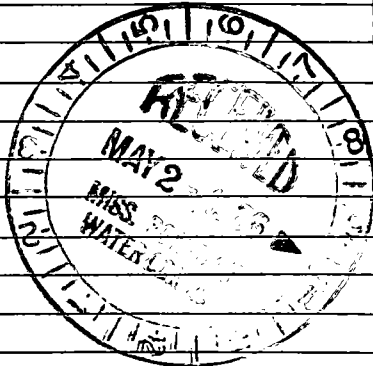

[Faint, illegible text and markings covering the upper and middle portions of the page, possibly bleed-through from the reverse side.]

82

 46
 36