

HARRISON

N 53

6-15-66

MISSISSIPPI BOARD OF WATER COMMISSIONERS

WATER WELL DRILLERS LOG

**CODED**

Date: 6-15, 1966, Driller: Sutton Well Works County Harrison  
(When well drilled) RIERA (Name) (Where well is located)

(1) Owner of Land: R. B. Riera  
(Name)  
Pass Christian, Miss.  
(Address)

(2) Location: SE 1/4, NE 1/4, Sec. 31 T85R 13W  
1 miles W, of Pass Christian  
(distance) (direction) (Nearest Town)

(3) Topography: flat  
(Hilly) (Flat) (Level)

(4) Purpose of Well: domestic  
(Domestic Irrigation  
Municipal, Industrial, Other)

Description & Color of Materials Sand, Clay, Red Clay, Shell, etc.	Thick- ness Feet	Depth Feet
<u>Sand</u>	<u>15</u>	<u>15</u>
<u>Clay</u>	<u>19</u>	<u>34</u>
<u>Sand</u>	<u>22</u>	<u>56</u>
<u>Clay</u>	<u>61</u>	<u>117</u>
<u>Sand</u>	<u>42</u>	<u>159</u>
<u>Sand</u>	<u>14</u>	<u>173</u>

Information upon completion of well:

(1) Diameter 2 inches.

(2) Total Depth 173 feet.

(3) Water Level 5 feet below top of ground.

(4) Cased to all, Size 2"

(5) Screen: Size 2", Length 5'

(6) Were any formations sealed against pollution?  
no.

No bed had blown away by coveils 1969  
Inf 1/25/73  
**CODED**

If YES depth of formation \_\_\_\_\_


Why \_\_\_\_\_

Drillers Remarks: \_\_\_\_\_

Yield in gpm: 15 gpm

Size pump: 1/2 hp

Type power: elec

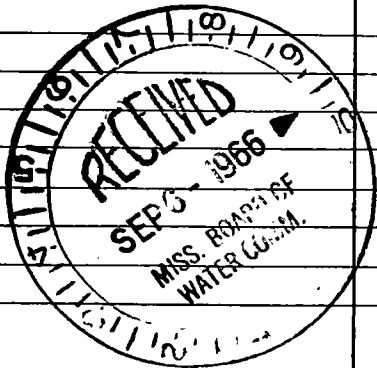

1918

Handwritten text, mostly illegible due to extreme fading and bleed-through from the reverse side of the page.