

Harrison
N 57
9-66

MISSISSIPPI BOARD OF WATER COMMISSIONERS

WATER WELL DRILLERS LOG **CODED**

Date: 9-1, 1966, Driller: Sutter Well Works County Harrison
(When well drilled) (Name) (Where well is located)

(1) Owner of Land: Ballie Roberts
(Name)
Pass Christian
(Address)

(2) Location: SW 1/4, SW 1/4, Sec. 32 T8S R 13 W
1 miles W, of PC
(distance) (direction) (Nearest Town)

(3) Topography: flat
(Hilly) (Flat) (Level)

(4) Purpose of Well: domestic
(Domestic Irrigation, Municipal, Industrial, Other)

Description & Color of Materials Sand, Clay, Red Clay, Shell, etc.	Thick- ness Feet	Depth Feet
<u>Clay</u>	<u>43</u>	<u>43</u>
<u>sand & gravel</u>	<u>10</u>	<u>53</u>
<u>Clay</u>	<u>107</u>	<u>160</u>
<u>sand & gravel</u>	<u>15</u>	<u>175</u>
<u>Clay</u>	<u>15</u>	<u>190</u>
<u>sand</u>	<u>25</u>	<u>215</u>

Information upon completion of well:

(1) Diameter 2 inches.

(2) Total Depth 215 feet.

(3) Water Level 2 feet below top of ground.

(4) Cased to all, Size 2"

(5) Screen: Size 2", Length 10'

(6) Were any formations sealed against pollution?
✓ yes, ✗ no.

CODED

If YES depth of formation Surface


Why _____

Drillers Remarks: _____

Yield in gpm: 10

Size pump: 1/2 hp

Type power: Elec

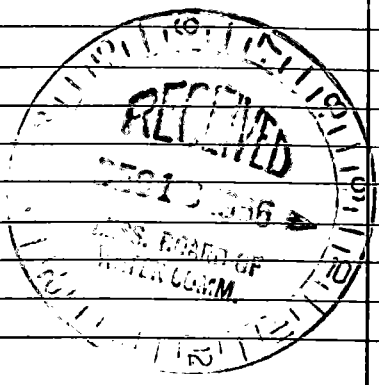

1914

Handwritten text, likely a ledger or record book, with columns and rows of entries. The text is extremely faint and illegible due to the quality of the scan. It appears to contain numerical data and possibly names or dates.