

Harrison
 N 59
 6-67

MISSISSIPPI
 BOARD OF WATER COMMISSIONERS
 416 North State Street
 Jackson, Mississippi 39201

CODED

WATER WELL DRILLERS LOG

6-13-1967 date well completed
 Sutter Well Works firm name
 Harrison county well located

LANDOWNER: JOE LADNER
 Ole Lisle, Miss.

description of formations encountered	from	to
Clay	0	18
Sand	18	82
Clay	82	117
Sand	117	133
Clay	133	202
sand	202	242

(mailing address)

WELL LOCATION:
 sec. 5 T 8 S R 13 E
 1 miles N of Ole Lisle
 (distance) (direction) (nearest town)

WELL PURPOSE: Home
 (home, irrigation, municipal, industrial)

WELL COMPLETION DATA:


- (1) diameter (inches) 2
- (2) total depth (feet) 247
- (3) static water level (feet) 17 below top of ground
- (4) casing galv. 237'
 (material) (depth)
 2" (size) if telescope see back.
- (5) screen 10' 237'
 (length) (depth to top)
 2" stainless steel
 (size) (material)
- (6) pump unknown
 (HP) (yield gpm)

CODED

(type power)
 (7) electric log no
 (yes or no)

(organization running log)


(8) how well bottom plugged BP Value

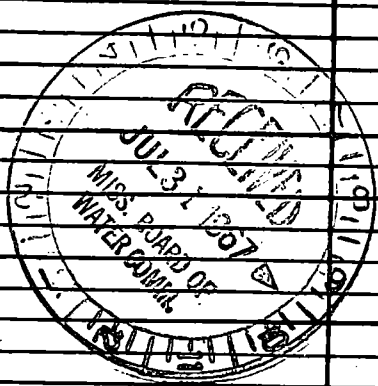

DRILLERS REMARKS:

If well telescopes please sketch and show depths.

GROUND LEVEL

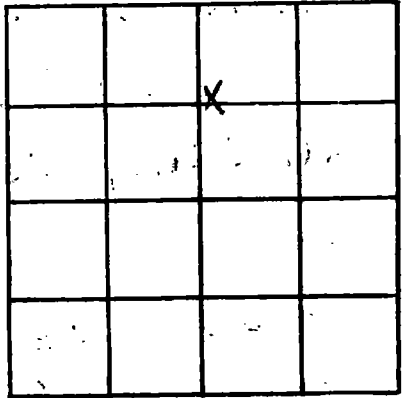

SECTION 6

Please indicate well location X.

ADDITIONAL INFORMATION

If more than one screen, show locations of each on sketch.