

HARRISON  
 NCO  
 7-67

MISSISSIPPI  
 BOARD OF WATER COMMISSIONERS  
 416 North State Street  
 Jackson, Mississippi 39201

WATER WELL DRILLERS LOG **CODED**

7-5 1967 Butter Well Works Harrison  
 date well completed firm name county well located

LANDOWNER: Wilson Lancia  
de Lisle, Miss.

description of formations encountered	from	to
Clay	0	20
sand	20	90
gravel	90	92
sand	92	98
Clay	98	202
sand	202	249

(mailing address)

WELL LOCATION:


sec. 5 T 8 N R. 13 E  
S W  
1 miles N of De Lisle  
 (distance) (direction) (nearest town)

WELL PURPOSE: Home  
 (home, irrigation, municipal, industrial)

WELL COMPLETION DATA:

- diameter (inches) 2
- total depth (feet) 249
- static water level (feet) 8 below above top of ground.
- casing galv. 244'  
 (material) (depth)  
2" if telescope see back.  
 (size)
- screen 5' 244'  
 (length) (depth to top)  
2" Stainless Steel  
 (size) (material)
- pump 1/2 6  
 (HP) (yield gpm)  
elec  
 (type power)
- electric log no  
 (yes or no)  
 (organization running log)
- how well bottom plugged BP Valve

**CODED**

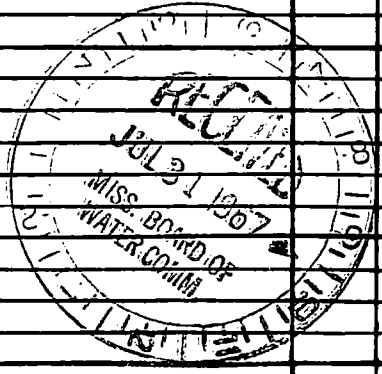

DRILLERS REMARKS:

