

Harrison  
N 61  
10-67

MISSISSIPPI  
 BOARD OF WATER COMMISSIONERS  
 416 North State Street  
 Jackson, Mississippi 39201

**CODED**

WATER WELL DRILLERS LOG

10-2 1967 Sutter Well Works Harrison  
 date well completed firm name county well located

LANDOWNER: Eugene Wescovich

Description of formations encountered	from	to
Clay	0	10
Sand & gravel	10	104
Clay	104	187
Sand	187	230
Clay	230	365
Sand	365	379
Clay	379	452
Sand	452	488
Clay	488	515
Sand	515	561

de Lisle  
Miss.  
 (mailing address)


WELL LOCATION:  
 sec 4 T 2 # R 13 E  
 S W  
 miles 1 1/2 of de Lisle  
 (distance) (direction) (nearest town)

WELL PURPOSE: Home  
 (home, irrigation, municipal, industrial)

WELL COMPLETION DATA:

- (1) diameter (inches) 2
- (2) total depth (feet) 561
- (3) static water level (feet) 13 <sup>below</sup> above top of ground.
- (4) casing galv. 546'  
 (material) (depth)  
2"  
 (size) If telescope see back.
- (5) screen 15' 546'  
 (length) (depth to top)  
2" Stainless Steel  
 (size) (material)
- (6) pump unknown  
 (HP) (yield gpm)  
 (type power)
- (7) electric log no  
 (yes or no)  
 (organization running log)
- (8) how well bottom plugged B.P. Value


**CODED**

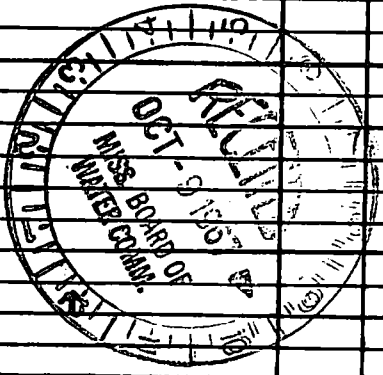

DRILLERS REMARKS:

If well telescopes please sketch and show depths.

GROUND LEVEL

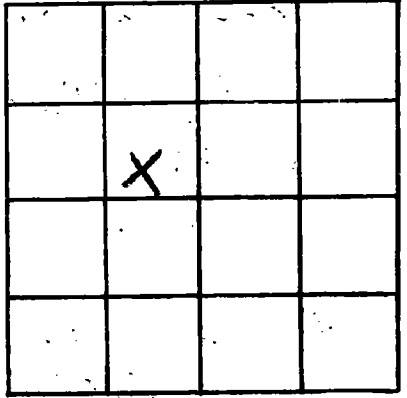

SECTION 4

Please indicate well location X.

ADDITIONAL INFORMATION

If more than one screen, show locations of each on sketch.