

MISSISSIPPI
BOARD OF WATER COMMISSIONERS
416 North State Street
Jackson, Mississippi 39201

CODED 1972

WATER WELL DRILLERS LOG

HARRISON
N72
1-11-72


Jan. 11 19 72 Sutter Well Works Harrison
date well completed firm name county well located

LANDOWNER: Wallace C. Walker	description of formations encountered		from	to
1728 Tulane Avenue	Sand		0	78
New Orleans, La.	Clay		78	88
(mailing address)	Sand		88	134
WELL LOCATION:	Clay		134	162
sec. 27 T. 8 R. 13 S. W	Sand		162	250
1 miles W of Pass Christian, Miss.	Clay-sand streaks		250	780
(distance) (direction) (nearest town)	Sand		780	800
WELL PURPOSE: sub-division	Clay		800	840
(home, irrigation, municipal, industrial)	Sand		840	924
WELL COMPLETION DATA:				
(1) diameter (inches) 6"				
(2) total depth (feet) 924'				
(3) static water level (feet) 16' below top of ground, top 44' galv.				
(4) casing blk. steel 804' (material) (depth)				
6" (size) if telescope see back.				
(5) screen 30' (length) 804' (depth to top)				
6" (size) stainless steel (material)				
(6) pump unknown (HP) (yield gpm)				
(type power)				
(7) electric log <u>yes</u> (yes or no)				
U.S.G.S. (organization running log)				
(8) how well bottom plugged B.P. Valve				
DRILLERS REMARKS:				

CODED

If well telescopes please sketch and show depths.

GROUND LEVEL

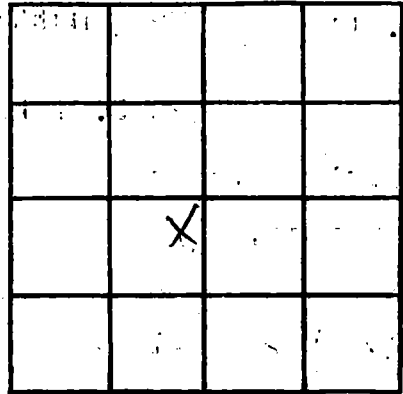

SECTION _____

Please indicate well location X.

ADDITIONAL INFORMATION

Lined area for additional information.

If more than one screen, show locations of each on sketch.