

HARRISON
N 81
6-6-72

MISSISSIPPI
BOARD OF WATER COMMISSIONERS
416 North State Street
Jackson, Mississippi 39201

WATER WELL DRILLERS & SERVICES CO. INC.

6/6/72
date well completed

ROUTE 1 BOX 618
BILBO, MISS 39532
firm name

Stennis
county well located

LANDOWNER: *Delia Davis*

description of formations encountered

from to

P.O. 601
Delia Davis
(mailing address)

Top Soil	1	3
Redd	3	5
White Sand Shale	5	39
Red Sand	39	51
White Sand	51	70
Blue Clay	70	430
Hard Blue Clay	430	450
Grey water Sand	450	475
Hard Blue Clay	475	505
Coarse water Sand	505	515
Hard Blue Clay	515	540
Grey water Sand	540	560
Coarse Water Sand	560	600

WELL LOCATION:

sec. *6* T. *13* N. R. *13* E. W.
Delia Davis
(distance) (direction) (nearest town)

WELL PURPOSE: *Shore*
(home, irrigation, municipal, industrial)

WELL COMPLETION DATA:

- (1) diameter (inches) 2"
- (2) total depth (feet) 600'
- (3) static water level (feet) 3 ^{below} above top of ground
- (4) casing PVC 580'
(material) (depth)
(size) if telescope see back.
- (5) screen 20' 580
(length) (depth to top)
2" PVC
(size) (material)
- (6) pump none 18
(HP) (yield gpm)
none
(type power)
- (7) electric log no
(yes or no)
(organization running log)


(8) how well bottom plugged
2" hole with steel

DRILLERS REMARKS:
Flowing well

NOV 1972

If well telescopes please sketch and show depths.

GROUND LEVEL

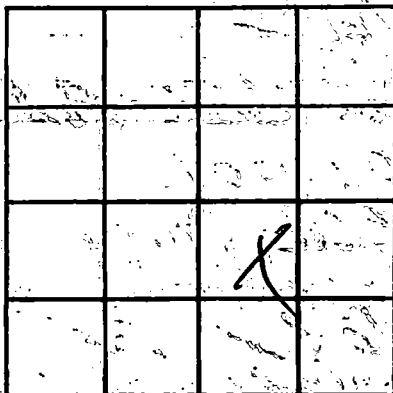

SECTION _____

Please indicate well location X.

ADDITIONAL INFORMATION

If more than one screen,
show locations of each on sketch.