

HARRISON
N 83
3-1-72

MISSISSIPPI
BOARD OF WATER COMMISSIONERS
416 North State Street
Jackson, Mississippi 39201

WATER WELL DRILLERS LOG

March 1 1972 McGil Well Works Harrison
date well completed firm name county well located

LANDOWNER:

W. S. Johnson
G. D. Helise MS
(mailing address)

WELL LOCATION:

sec. 6 T. 8 N R. 13 E
4 1/2 miles N of Pass Christian
(distance) (direction) (nearest town)

WELL PURPOSE:

Home (home, irrigation, municipal, industrial)

WELL COMPLETION DATA:

- (1) diameter (inches) 2"
- (2) total depth (feet) 526'
- (3) static water level (feet) _____ below above top of ground. - flowing 11 gal. a min.
- (4) casing gal 5 1/4" (material) (depth)
(size) If telescope see back.
- (5) screen 10 (length) (depth to top)
2" 5.5. (size) (material)
- (6) pump 7 (HP) 11 (yield gpm)
~~Electric~~ (type power)
- (7) electric log no (yes or no)
no. (organization running log)
- (8) how well bottom plugged sand spark

description of formations encountered


from to

Topsoil	0	4
clay	4	18
sand	18	65
gravel	65	85
clay	85	487
course sand	487	526

DRILLERS REMARKS:

If well telescopes please sketch and show depths.

GROUND LEVEL

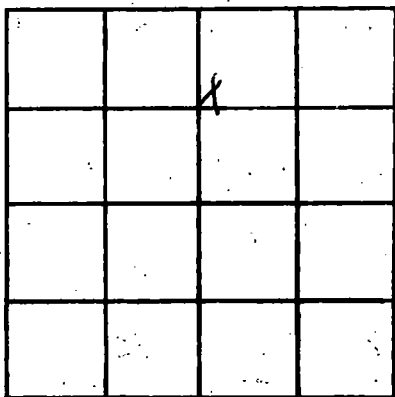

SECTION 6

Please indicate well location X.

ADDITIONAL INFORMATION

If more than one screen, show locations of each on sketch.